




Scale 1:7500

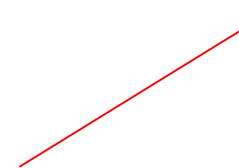


Cinderhill, Completion Date 10/10/2018, 10mm CGSC, 65 PSV,
160 Tonne, Inlay, 40mm Thick

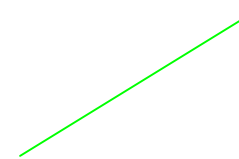

Drybridge St, Completion Date 30/11/2018, 10mm CGSC, 65 PSV,
347 Tonne, Inlay, 40mm (including 40m of Rockfield Rd and 15m of
Wonastow Rd approaching R/A's)

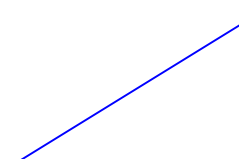



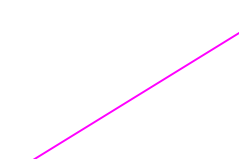

Monnow St, Completion Date 05/10/2018, 10mm CGSC, 65 PSV, 411 Tonnes, Inlay, 40mm Thick



Portal Road, East of Troy Depot to Traffic Island above petrol station,
Completion Date 06/11/2018, 10 CGSC, 65 PSV. 674 Tonnes, Overlay,
40mm Thick

Toll House to East of Troy Depot - Portal Road, Completion Date
12/10/2018, 10mm CGSC, 65 PSV, 280 Tonne, Inlay, 40mm Thick

Scale 1:2500

 <p> ROGER HOGGINS HEAD OF OPERATIONS PAUL KEEBLE GROUP ENGINEER HIGHWAY & FLOOD MANAGEMENT </p>			Job Title Monmouth	Drawing Title As Built	Drawn By LJ	Checked IB	Date JAN '19	Description M101/CON/05 - Monmouth	Drawn 	Chkd
 <p> PAUL KEEBLE GROUP ENGINEER HIGHWAY & FLOOD MANAGEMENT </p>			Job Title Monmouth	Drawing Title As Built	Drawn By LJ	Checked IB	Date JAN '19	Description M101/CON/05 - Monmouth	Drawn 	Chkd