


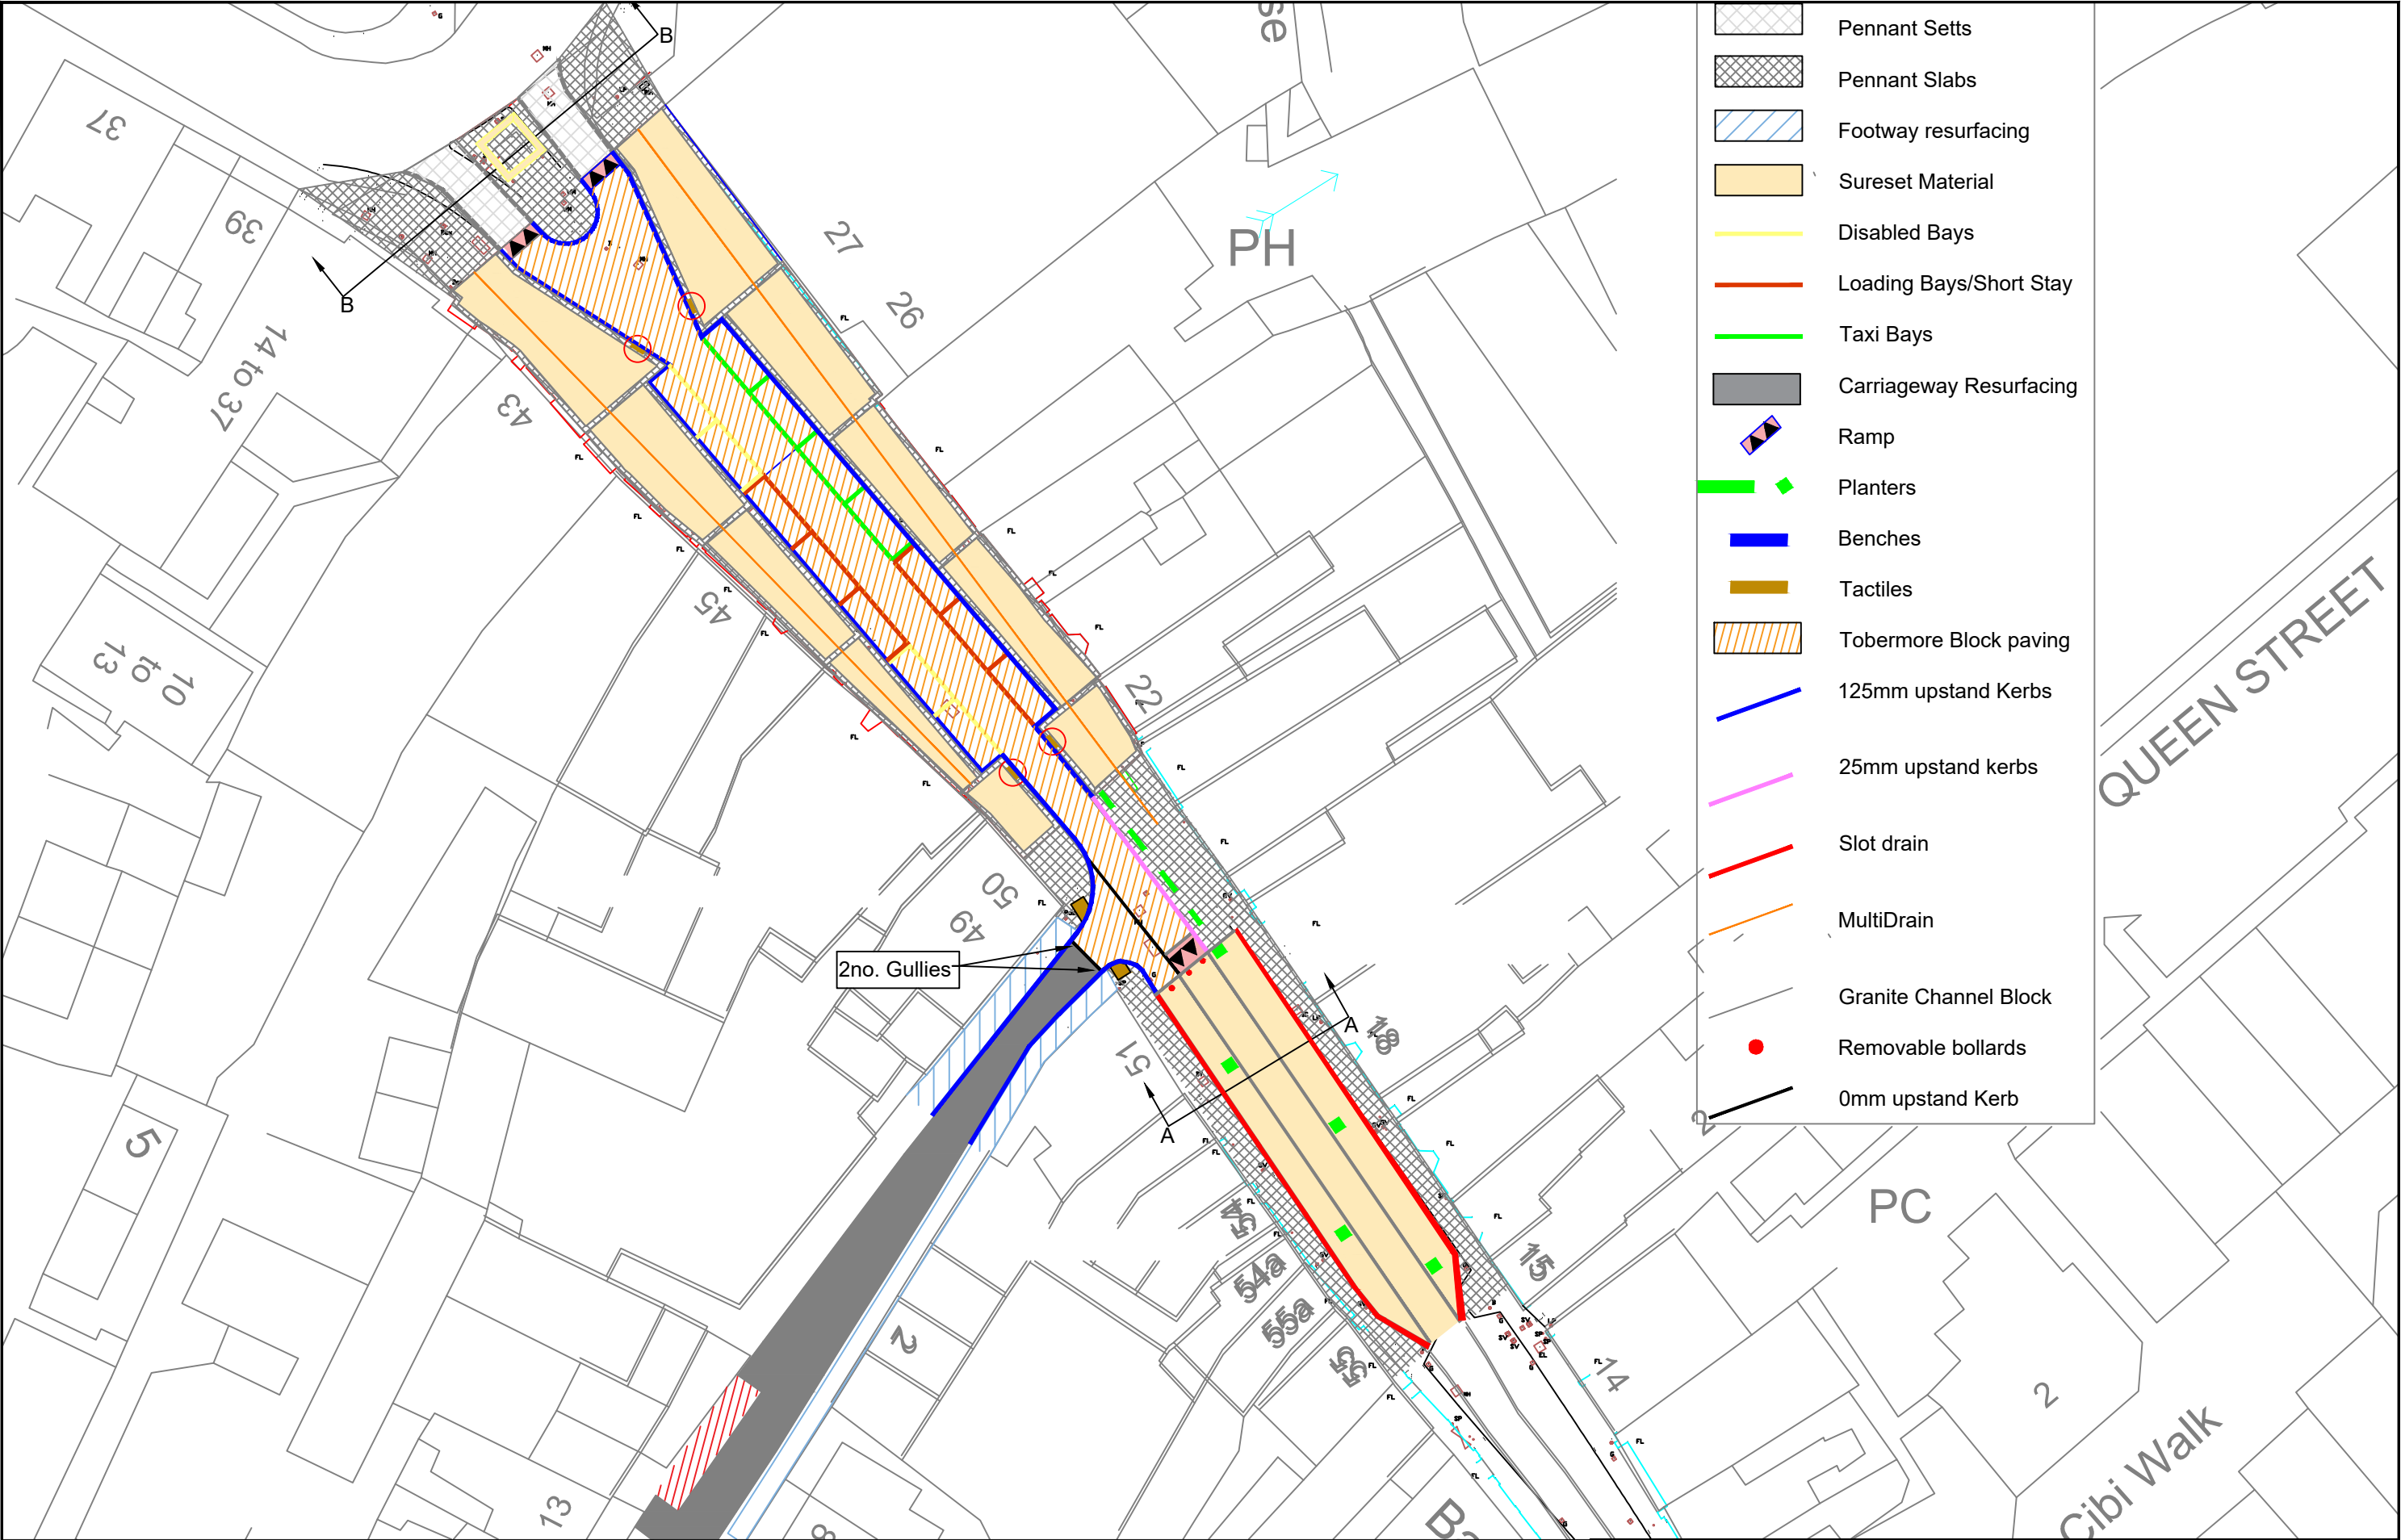

 ROGER HOGGINS HEAD OF OPERATIONS PAUL KEEBLE GROUP ENGINEER HIGHWAY & FLOOD MANAGEMENT			Job Title M114 Abergavenny public realm Phase 3	Drawing Title As Built	Drawn By R.Davies Scale 1:500 @ A3	Rev No. Date Description Checked I.Brain Date Sept 2019	Drawn Chkd Rev P

THIS MAP IS REPRODUCED FROM ORDNANCE SURVEY MATERIAL WITH THE PERMISSION OF ORDNANCE SURVEY ON BEHALF OF THE CONTROLLER OF HER MAJESTY'S STATIONERY OFFICE. COPYRIGHT. UNAUTHORISED REPRODUCTION INFRINGES CROWN COPYRIGHT AND MAY LEAD TO PROSECUTION OR CIVIL PROCEEDINGS. MONMOUTHSHIRE COUNTY COUNCIL LA09012L2000