

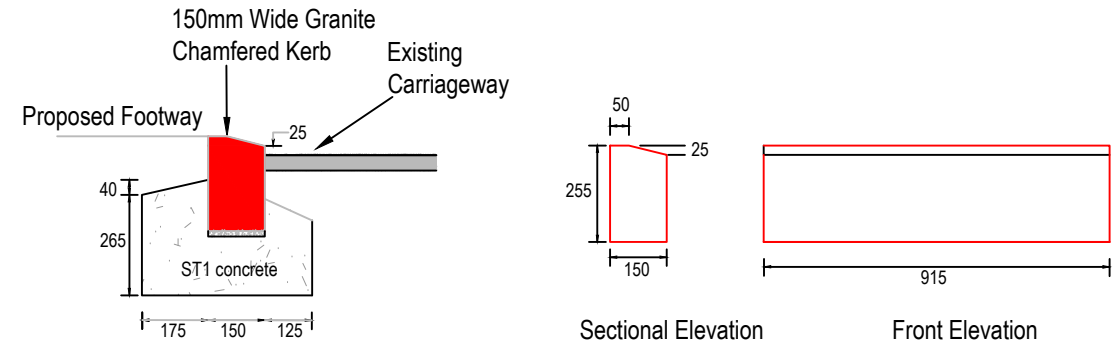
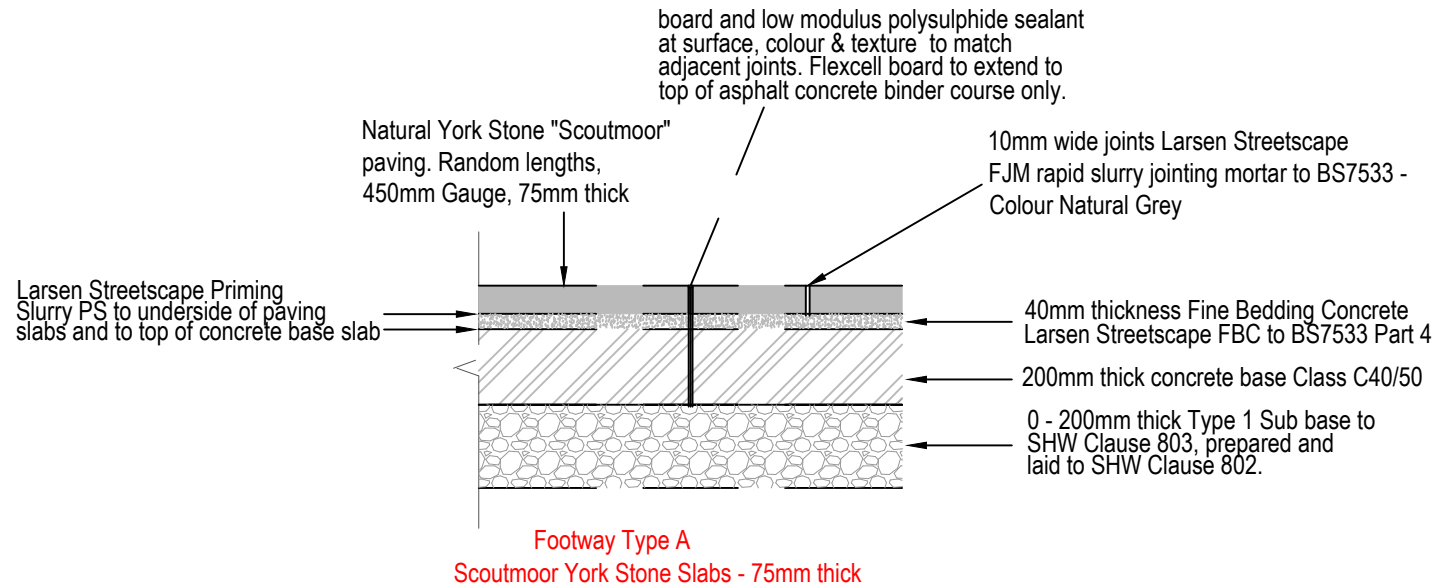





<div> monmouthshire COUNTY COUNCIL <i>sur fyrrwy</i></div> <div>ROGER HOGGINS HEAD OF OPERATIONS PAUL KEEBLE GROUP ENGINEER HIGHWAY & FLOOD MANAGEMENT</div>	Job Title M047 Monmouth Town Public Realm Phase 1	Drawn By R.Davies	Checked	<div> N W E S</div>
		Scale 1:500 @A3	Date August 2020	
	Drawing Title General Layout	Drawing No. M047/CON/02	Rev C	
	THIS MAP IS REPRODUCED FROM ORDNANCE SURVEY MATERIAL WITH THE PERMISSION OF ORDNANCE SURVEY ON BEHALF OF THE CONTROLLER OF HER MAJESTY'S STATIONERY OFFICE. COPYRIGHT. UNAUTHORISED REPRODUCTION INFRINGES CROWN COPYRIGHT AND MAY LEAD TO PROSECUTION OR CIVIL PROCEEDINGS. MONMOUTHSHIRE COUNTY COUNCIL LA09012L2000			

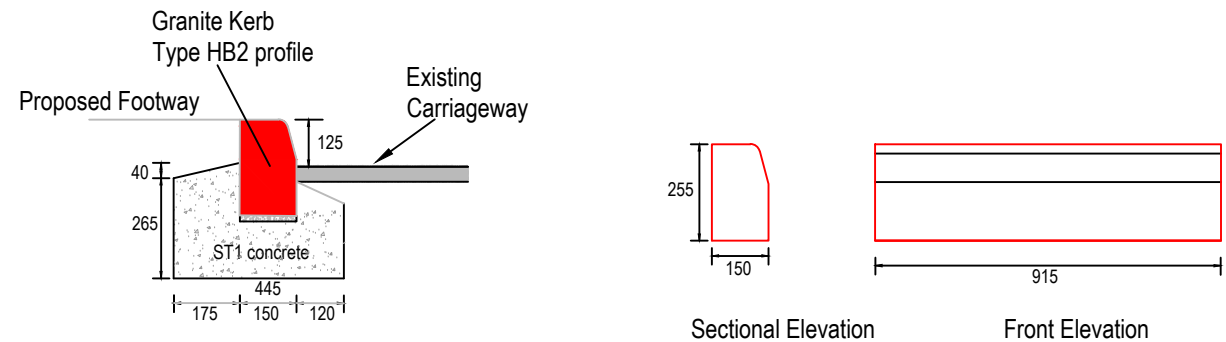


KERB TYPE 1
Chamfered Granite Kerb (special)

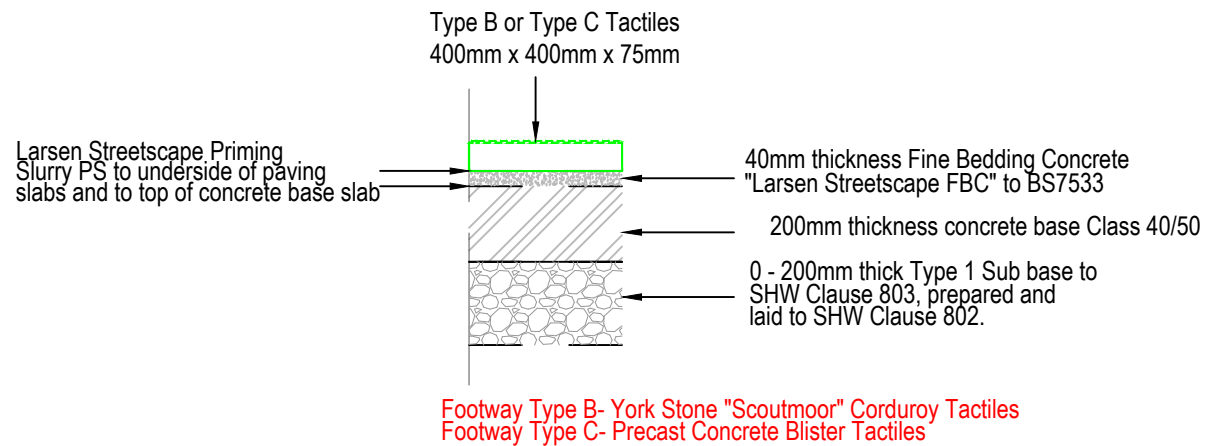

KERB TYPE 2
125mm Upstand HB2 Granite Kerb

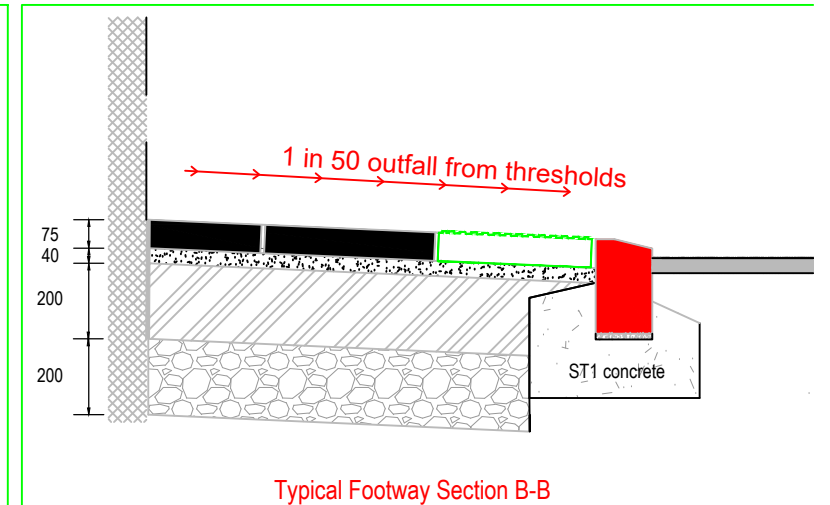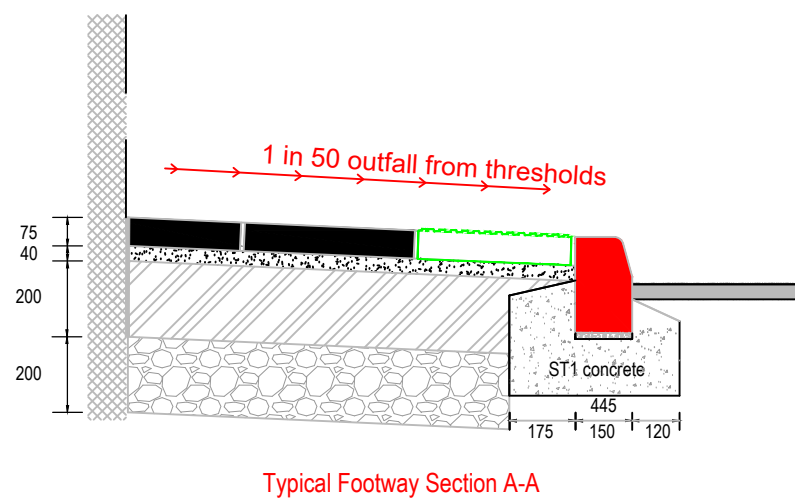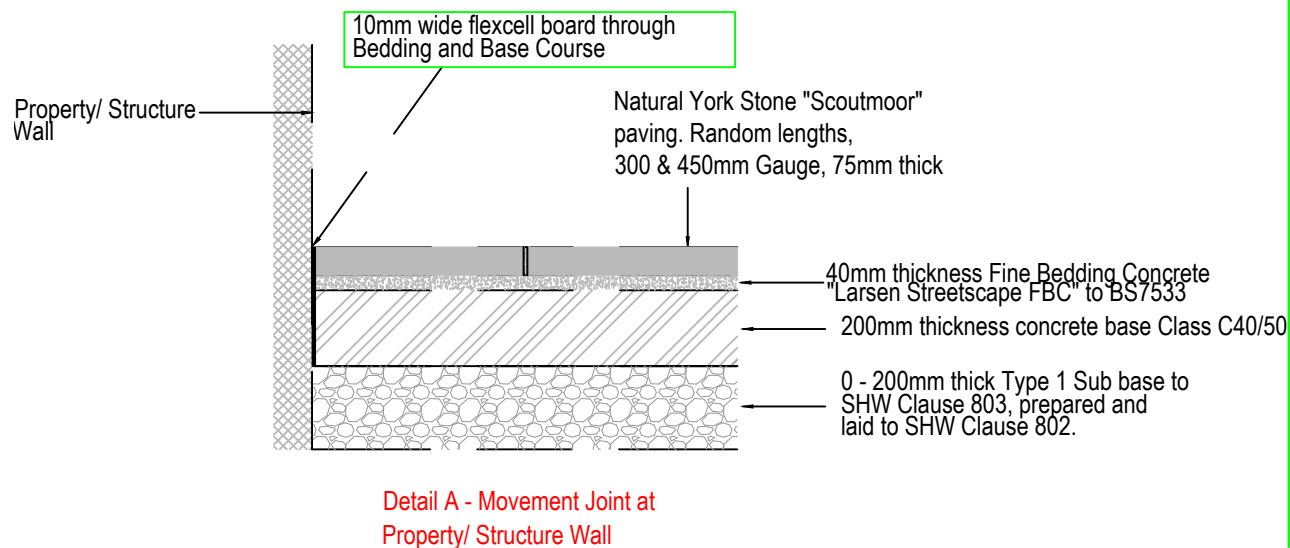


		ROGER HOGGINS HEAD OF OPERATIONS PAUL KEEBLE GROUP ENGINEER HIGHWAY & FLOOD MANAGEMENT				Job Title M047 Monmouth Town Public Realm Phase 1	Drawing Title Footway Details	Drawn By R.Davies Scale 1:20	Checked P.Deidun Date	Rev No. Date Description	Drawing No. M047/CON/04 <small>THIS MAP IS REPRODUCED FROM ORDNANCE SURVEY MATERIAL WITH THE PERMISSION OF ORDNANCE SURVEY ON BEHALF OF THE CONTROLLER OF HER MAJESTY'S STATIONERY OFFICE. COPYRIGHT. UNAUTHORISED REPRODUCTION INFRINGES CROWN COPYRIGHT AND MAY LEAD TO PROSECUTION OR CIVIL PROCEEDINGS. MONMOUTHSHIRE COUNTY COUNCIL LA89012L2000</small>	Drawn Chkd Rev
--	--	---	--	--	--	---	----------------------------------	---	---------------------------------	--------------------------------	---	----------------------

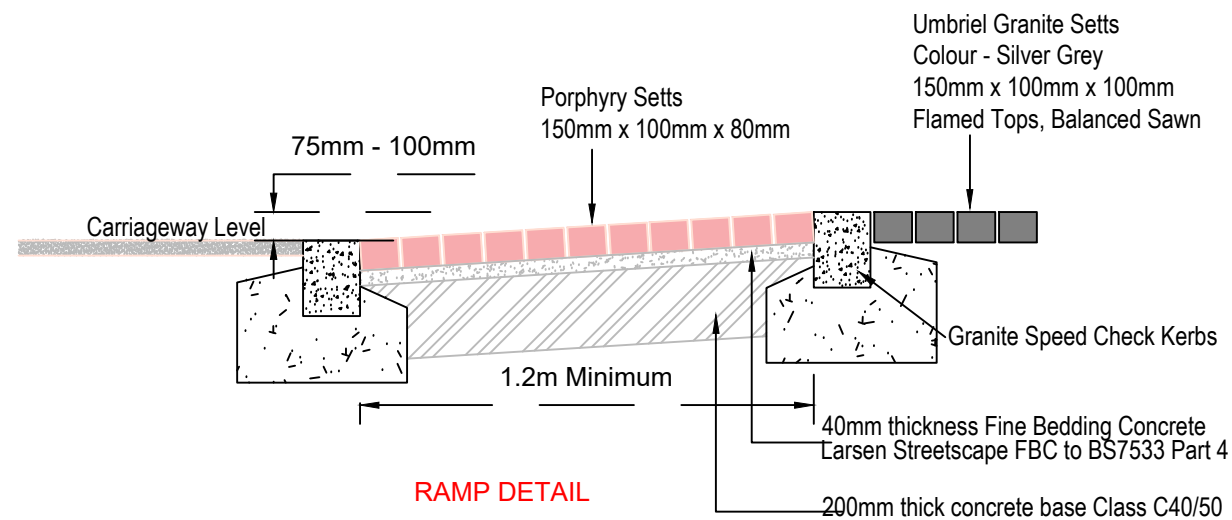





RAMP DETAIL

Scale 1:20

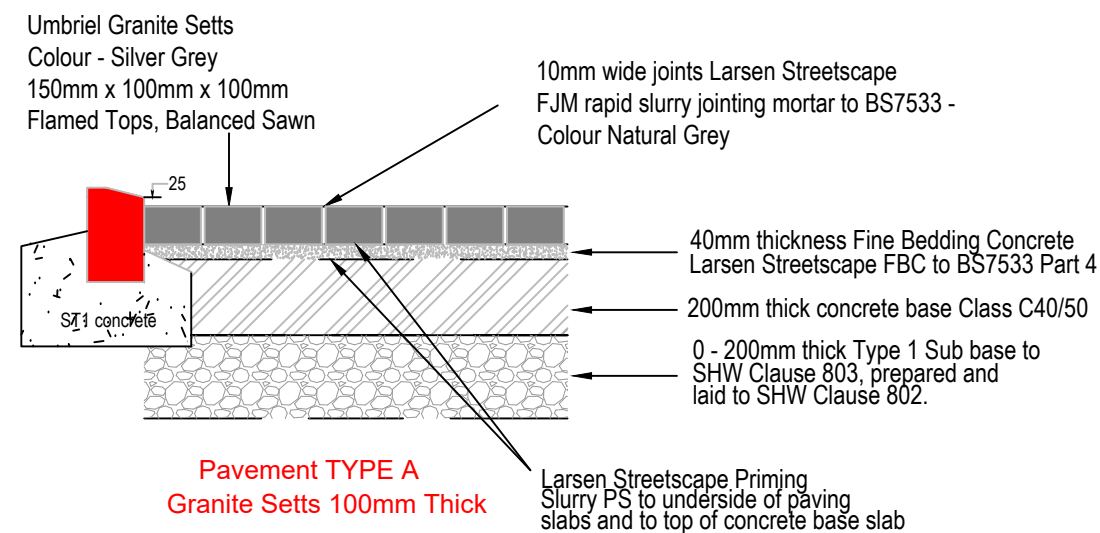


Pavement TYPE A
Granite Setts 100mm Thick

Scale 1:20

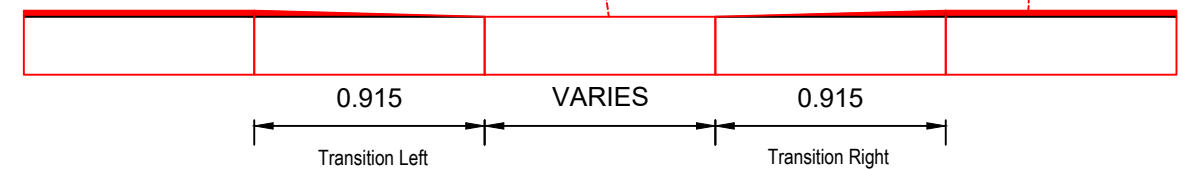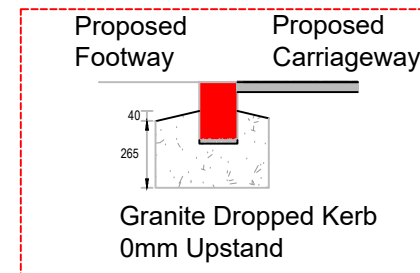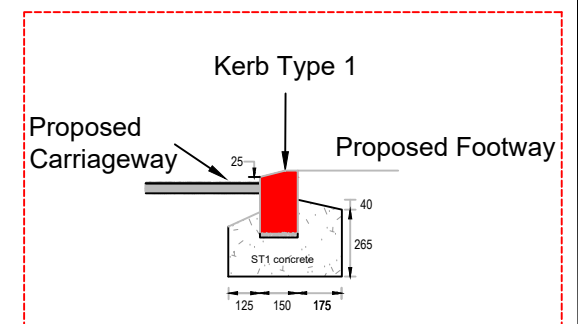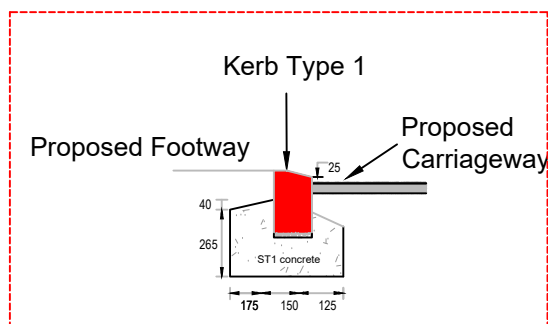

Scale 1:30

DROPPED CROSSING DC1
Granite Kerb (special) to
Square Dropped Kerb

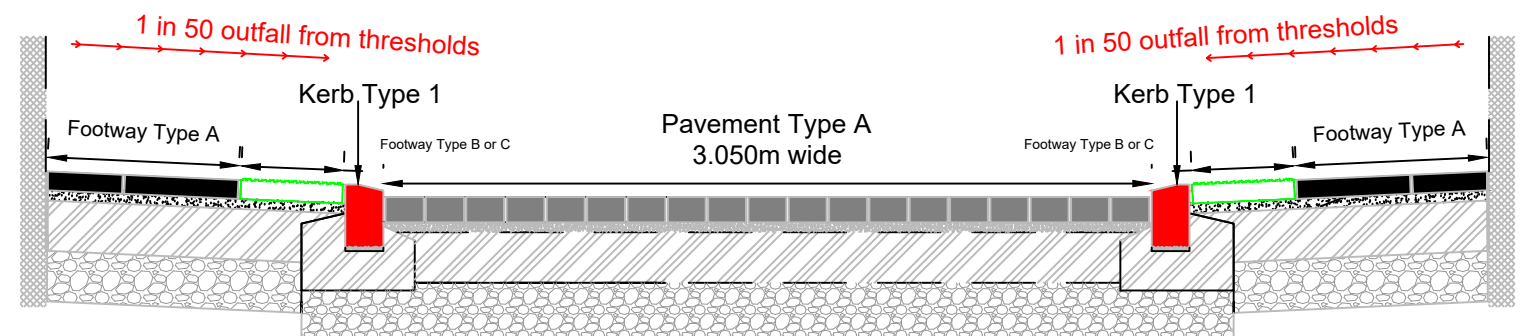

Section C - C

Scale 1:30



ROGER HOGGINS
HEAD OF OPERATIONS
PAUL KEEBLE
GROUP ENGINEER HIGHWAY & FLOOD MANAGEMENT



Job Title
M047 Monmouth Town Public Realm
Phase1

Drawing Title
Construction Details


Drawn By
R.Davies

Scale
As Shown

Rev No.	Date	Description	Drawn	Chkd
1				

Checked P.Deidun	Date	Drawing No. M047/CON/05	Rev

THIS MAP IS REPRODUCED FROM ORDNANCE SURVEY MATERIAL WITH THE PERMISSION OF ORDNANCE SURVEY ON BEHALF OF THE CONTROLLER OF HER MAJESTY'S STATIONERY OFFICE. COPYRIGHT. UNAUTHORISED REPRODUCTION INFRINGES CROWN COPYRIGHT AND MAY LEAD TO PROSECUTION OR CIVIL PROCEEDINGS. MONMOUTHSHIRE COUNTY COUNCIL LA09012L2000

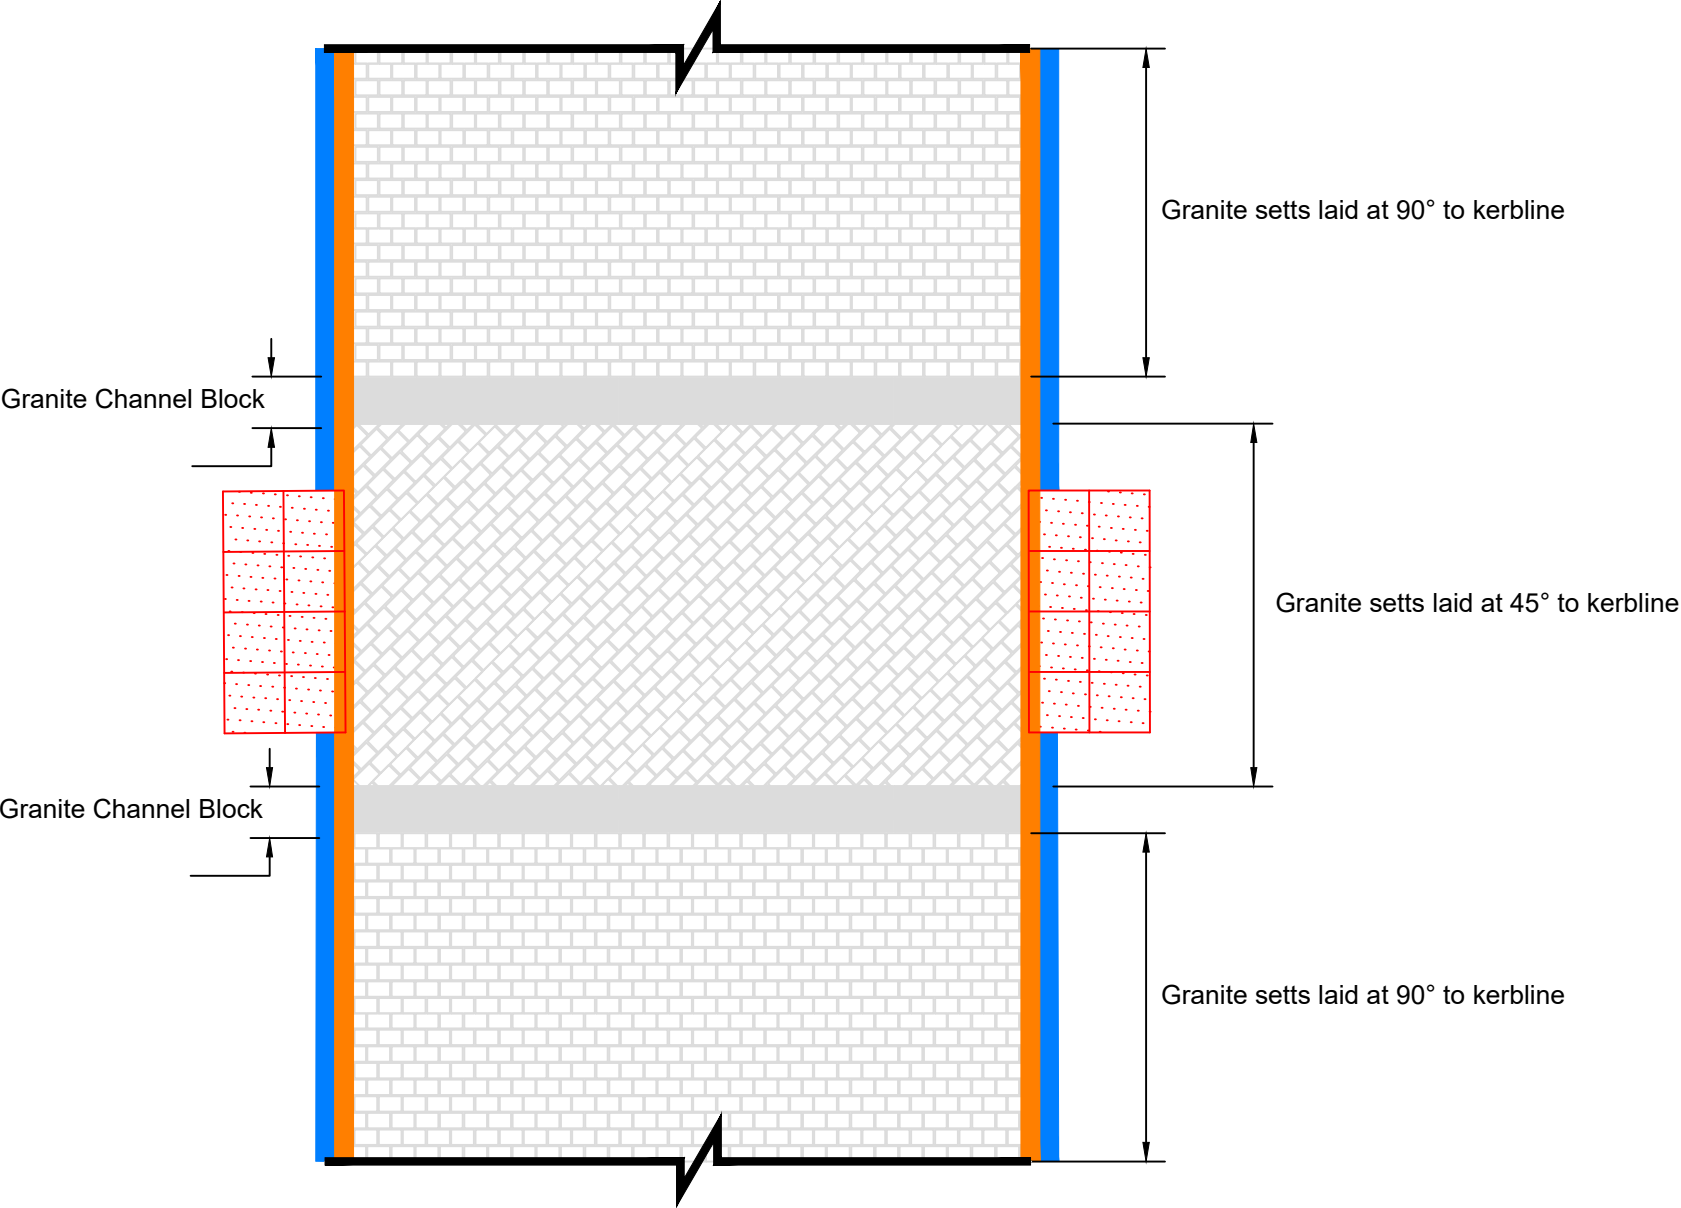


Uncontrolled Crossing Point Laying Pattern


monmouthshire
COUNTY COUNCIL
str ynnu

ROGER HOGGINS
HEAD OF OPERATIONS
PAUL KEEBLE
GROUP ENGINEER
HIGHWAY & FLOOD MANAGEMENT

Job Title
M047 Monmouth Town Public Realm
Phase 1

Drawing Title
Crossing Point Detail

Rev No.	Date	Description	Drawn	Chkd
Drawn By R.Davies		Checked		
Scale 1:50		Date March 2020		
Drawing No. M047/CON/11				Rev
THIS MAP IS REPRODUCED FROM ORDNANCE SURVEY MATERIAL WITH THE PERMISSION OF ORDNANCE SURVEY ON BEHALF OF THE CONTROLLER OF HER MAJESTY'S STATIONERY OFFICE COPYRIGHT: UNAUTHORISED REPRODUCTION INFRINGES CROWN COPYRIGHT AND MAY LEAD TO PROSECUTION OR CIVIL PROCEEDINGS. MONMOUTHSHIRE COUNTY COUNCIL LA09012L2000				

