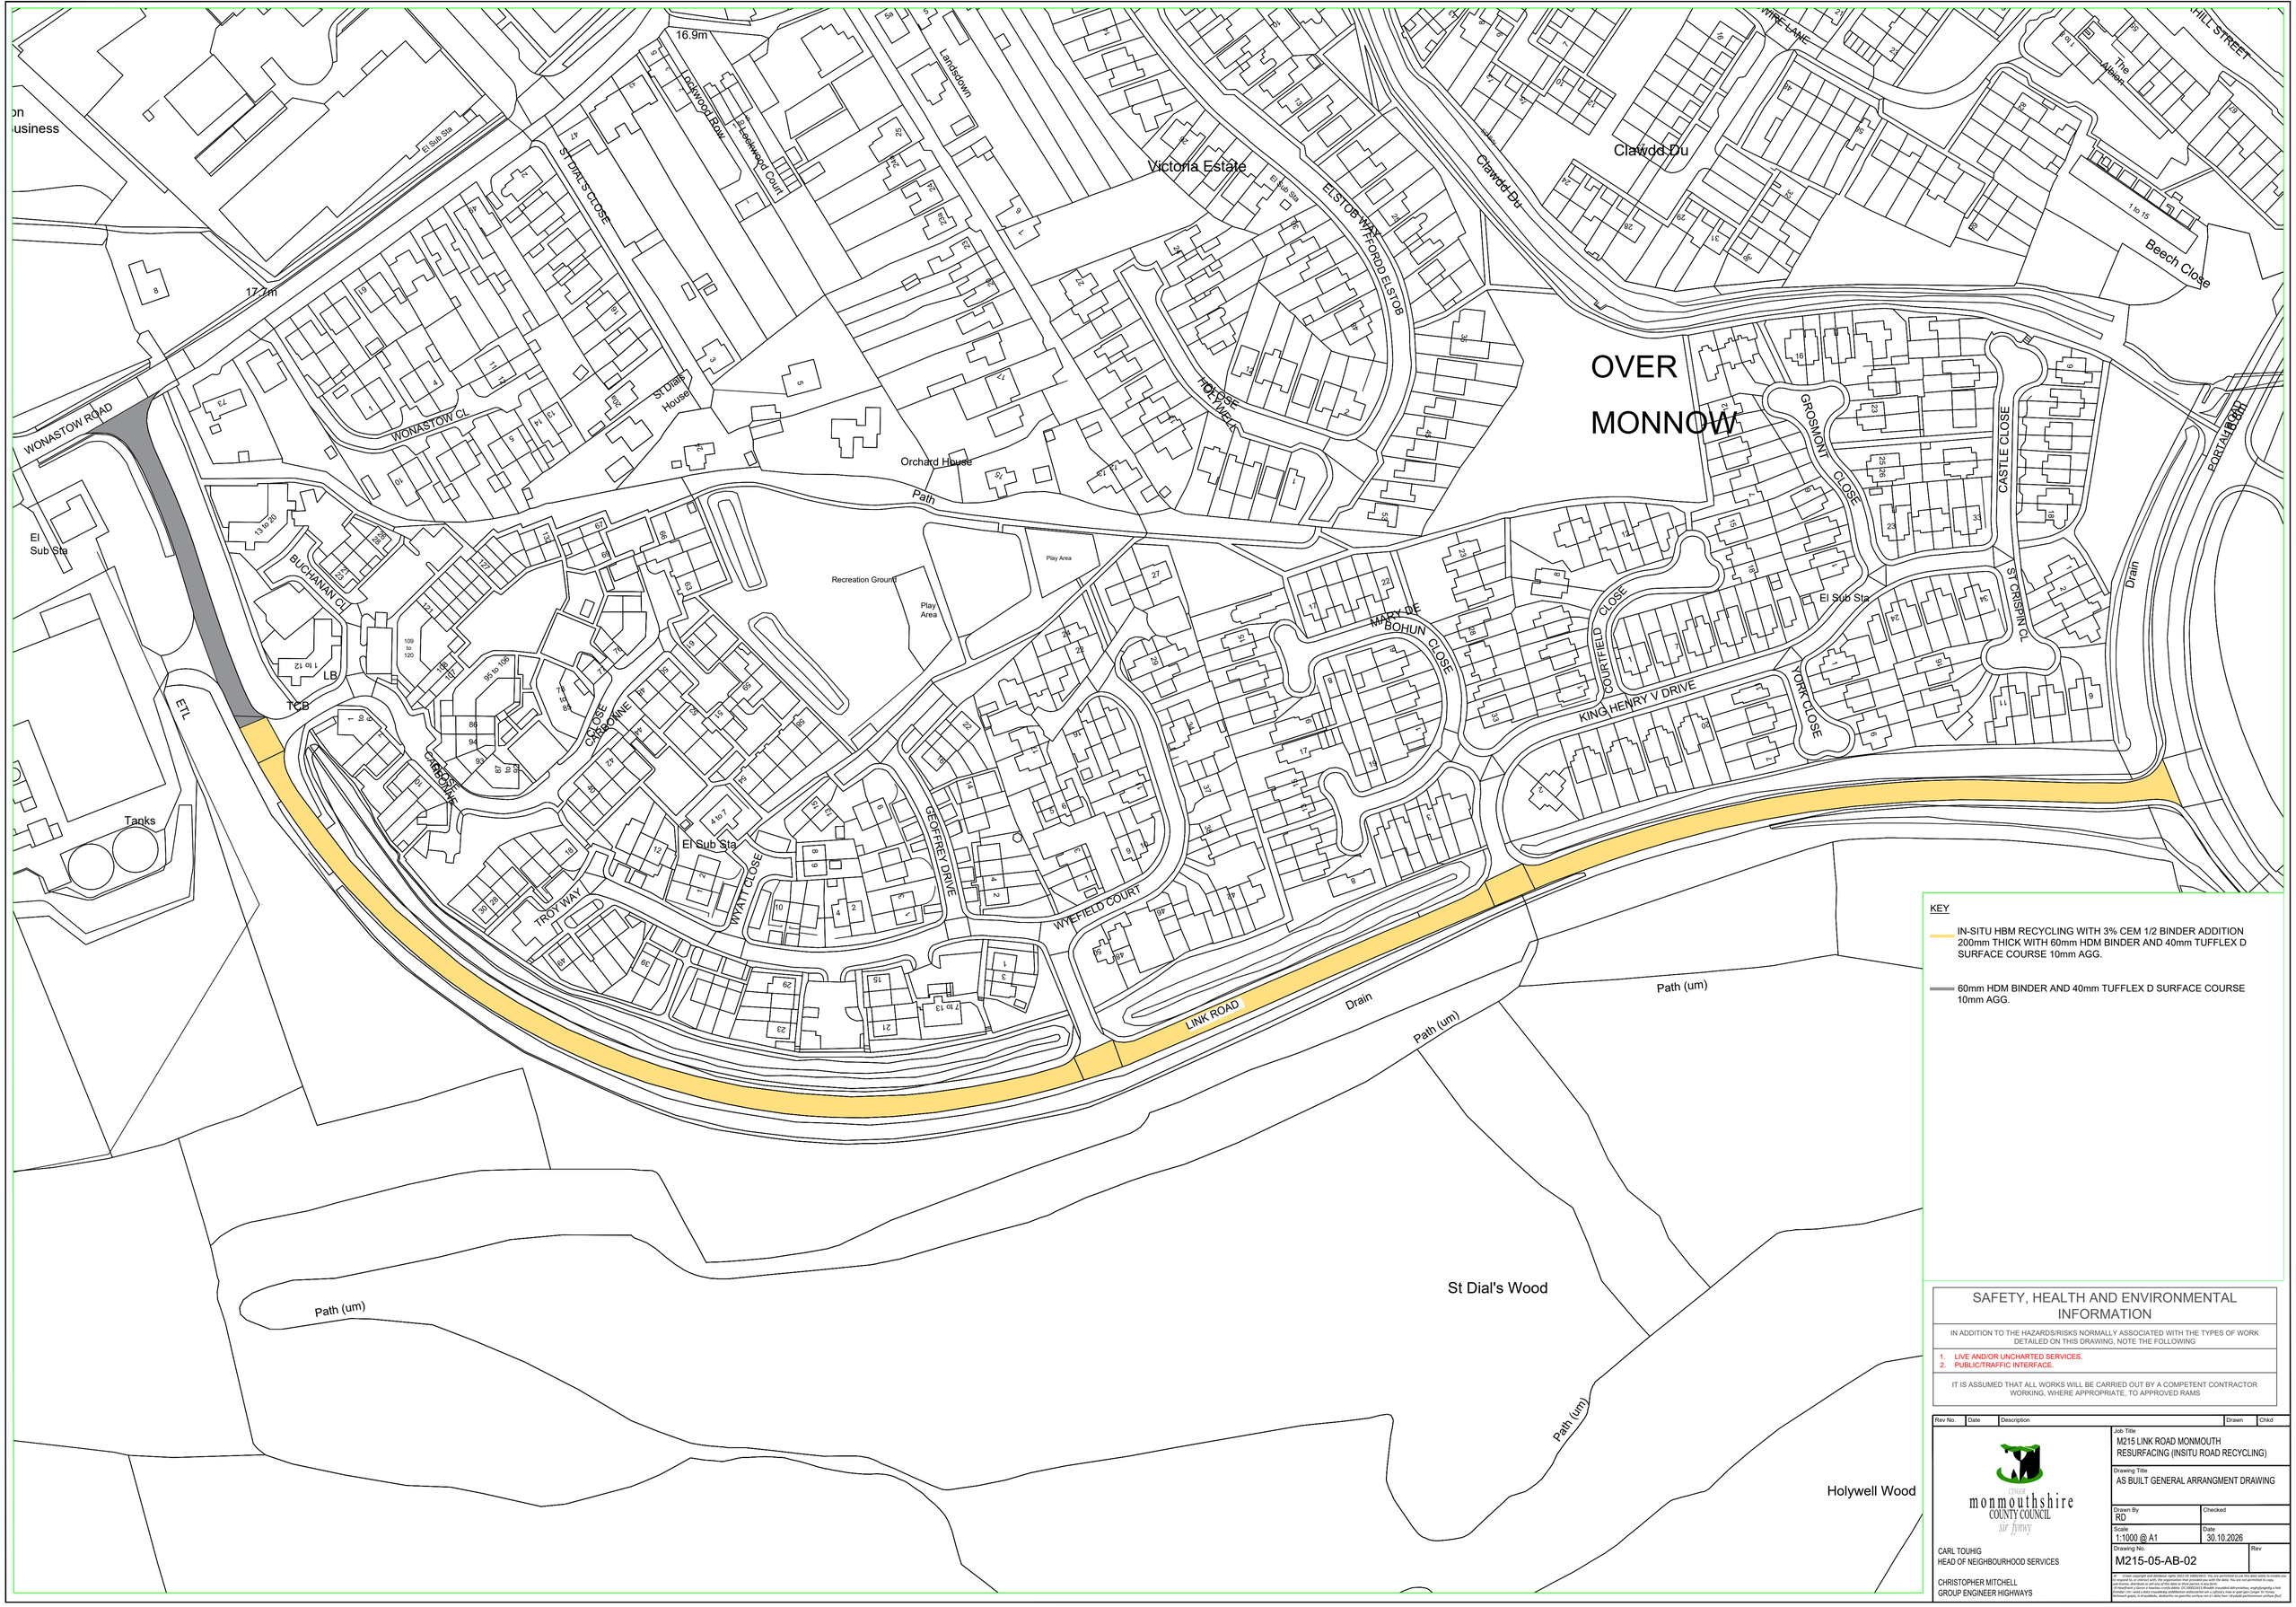


KEY

IN-SITU HBM RECYCLING WITH 3% CEM 1/2 BINDER ADDITION 200mm THICK WITH 60mm HDM BINDER AND 40mm TUFFLEX D SURFACE COURSE 10mm AGG.

60mm HDM BINDER AND 40mm TUFFLEX D SURFACE COURSE 10mm AGG.

SAFETY, HEALTH AND ENVIRONMENTAL INFORMATION

IN ADDITION TO THE HAZARDS/RISKS NORMALLY ASSOCIATED WITH THE TYPES OF WORK DETAILED ON THIS DRAWING, NOTE THE FOLLOWING

1. LIVE AND/OR UNCHARTED SERVICES.
2. PUBLIC/TRAFFIC INTERFACE.

IT IS ASSUMED THAT ALL WORKS WILL BE CARRIED OUT BY A COMPETENT CONTRACTOR WORKING, WHERE APPROPRIATE, TO APPROVED RAMS

Rev No.	Date	Description	Drawn	Chkd

Cyngor monmouthshire COUNTY COUNCIL sir fynwy

CARL TOUHIG
HEAD OF NEIGHBOURHOOD SERVICES

CHRISTOPHER MITCHELL
GROUP ENGINEER HIGHWAYS

Job Title
M215 LINK ROAD MONMOUTH
RESURFACING (INSITU ROAD RECYCLING)

Drawing Title
AS BUILT GENERAL ARRANGMENT DRAWING

Drawn By	Checked
RD	

Scale	Date
1:1000 @ A1	30.10.2026

Drawing No.	Rev
M215-05-AB-02	

© Crown copyright and database rights 2022 OS 100023403. You are permitted to use this data solely to enable you to respond to, or interact with, the organisation that provided you with the data. You are not permitted to copy, sub-license, distribute or sell any of this data to third parties in any form.
Mae hawlfraint y Goron a hawliau cronfa ddata yn berthnasol i'r wybodaeth hon. Caniateir defnyddio'r wybodaeth hon yn unig i alluogi ymateb i neu ryngweithio ag'r sefydliad a roddodd y data i chi. Ni chaniateir i chi gopïo, is-drwyddedu, dosbarthu na gwerthu unrhyw ran o'r data hwn i drydydd partïon mewn unrhyw ffurf.